# JLG architects

## **ADDENDUM**

JLG 16076 Phillips Aquatics Community Center

RE: Addendum 4
Issued: October 7, 2016

#### ADDENDUM #: 4

## NOTICE TO CONTRACTORS

This Addendum is prepared to supplement information presented in the Drawings and Project Manual - dated September 22, 2016, Addendum #1, #2 and #3 - dated September 30, October 3 and October 6 respectively, for the above referenced project. All additions, changes, omissions and conditions listed herein shall become an integral part of the Contract Documents.

#### SITE VISIT

An additional <u>optional</u> site visit for interested bidders will be held on <u>Tuesday the 11<sup>th</sup></u>, at 10:30 AM at the Phillips Community Center - 2323 11<sup>th</sup> Avenue S., Minneapolis, MN.

# CLARIFICATIONS:

Bidders <u>not</u> to include SAC charges in Base Bid. The charges will be reimbursed via Change Order with no markup.

# **SPECIFICATIONS**

1. SECTION 10 2800 - TOILET, BATH AND LAUNDRY ACCESSORIES

# APPROVED EQUALS

The following products have been approved for use on this project. All approved products must still meet all product specifications as listed in the product specification section.

Section	Material ID or description	Basis of Design	Approved Equal
10 5100	Lockers	Guardian by Penco Products,	WEC All Welded Plus
		Inc.	Lockers by Elite Storage
			Products, WEC
			Manufacturing

# **DRAWINGS**

- 1. A612 INTERIOR ELEVATIONS
  - O Detail 1A & 1B/A612 Typical hook mounting in both existing and new pool areas, location as shown on drawings; Change solid surface to Aluminum C channel, 16 ga. Mount hooks to C channel; mount channel to precast wall panels with ½" wedge anchors @ 48: o.c. max, coordinate anchors location with precast panels manufacturer.
- 2. C101 DEMOLITION PLAN
  - O Update pavement removal area on E 24<sup>th</sup> Street.

# 3. C301 - GRADING AND EROSION CONTROL PLAN

O Clarification of high water levels.

# 4. G401 - UTILITY PLAN

- O Clarification of high water levels.
- Clarification of acceptable pipe materials.
- o Realignment of catch basin lead on E 24th St.
- Added storm sewer structure numbers.
- O Clarification of gravity separator and skimmer locations. Eliminate both in CBMH 4, both skimmer and separator in CBMH 3, and skimmer only in CBMH 2. There are no skimmers on separators in the other structures.
- O Clarification of pipe sizes between CBMH 2 & 3 and the infiltration storage system.
- o Increase the size of pipe between CBMH 2 and STMH 1 to 18".
- Add City contact for required utility inspections.

## 5. C502 - DETAILS

O Detail 11 - add structure diameter.

# 6. C503 - DETAILS

- o Clarification of system dimensions.
- O Clarification of pipe sizes.

## **END OF ADDENDUM**

# SECTION 10 2800 - TOILET, BATH, AND LAUNDRY ACCESSORIES

#### PART 1 GENERAL

#### 1.01 SECTION INCLUDES

- A. Accessories for toilet rooms and utility rooms.
- B. Grab bars.

#### 1.02 RELATED REQUIREMENTS

A. Section 10 2113.19 - Plastic Toilet Compartments.

#### 1.03 REFERENCE STANDARDS

- A. ASTM A269/A269M Standard Specification for Seamless and Welded Austenitic Stainless Steel Tubing for General Service; 2015.
- B. ASTM A653/A653M Standard Specification for Steel Sheet, Zinc-Coated (Galvanized) or Zinc-Iron Alloy-Coated (Galvannealed) by the Hot-Dip Process; 2015.
- C. ASTM A666 Standard Specification for Annealed or Cold-Worked Austenitic Stainless Steel Sheet, Strip, Plate, and Flat Bar; 2015.
- D. ASTM C1036 Standard Specification for Flat Glass; 2011.
- E. ASTM C1503 Standard Specification for Silvered Flat Glass Mirror; 2008 (Reapproved 2013).
- F. ASTM F2285 Standard Consumer Safety Performance Specification for Diaper Changing Tables for Commercial Use; 2004 (Reapproved 2010).

#### 1.04 SUBMITTALS

- A. See Section 01 3000 Administrative Requirements, for submittal procedures.
- B. Product Data: Submit data on accessories describing size, finish, details of function, and attachment methods.
- Manufacturer's Installation Instructions: Indicate special procedures and conditions requiring special attention.

## **PART 2 PRODUCTS**

## 2.01 MANUFACTURERS

- A. Toilet Accessories:
  - 1. AJW Architectural Products: www.ajw.com.
  - 2. ASI American Specialties, Inc: www.americanspecialties.com.
  - 3. Bradley Corporation: www.bradleycorp.com.
  - 4. Bobrick Washroom Equipment, Inc: www.bobrick.com.
  - 5. Substitutions: Section 01 6000 Product Requirements.
- B. All items of each type to be made by the same manufacturer.

#### 2.02 MATERIALS

- A. Accessories General: Shop assembled, free of dents and scratches and packaged complete with anchors and fittings, steel anchor plates, adapters, and anchor components for installation.
  - 1. Grind welded joints smooth.
  - 2. Fabricate units made of metal sheet of seamless sheets, with flat surfaces.
- B. Stainless Steel Sheet: ASTM A666, Type 304.
- C. Stainless Steel Tubing: ASTM A269/A269M, Type 304 or 316.
- D. Galvanized Sheet Steel: Hot-dipped galvanized steel sheet, ASTM A653/A653M, with G90/Z275 coating.
- E. Mirror Glass: Annealed float glass, ASTM C1036 Type I, Class 1, Quality Q2, with silvering, protective and physical characteristics complying with ASTM C1503.
- F. Fasteners, Screws, and Bolts: Hot dip galvanized; tamper-proof; security type.

#### 2.03 FINISHES

- A. Stainless Steel: No. 4 Brushed finish, unless otherwise noted.
- B. Baked Enamel: Pretreat to clean condition, apply one coat primer and minimum two coats epoxy baked enamel.
- C. Back paint components where contact is made with building finishes to prevent electrolysis.

#### 2.04 TOILET ROOM ACCESSORIES

- A. Toilet Paper Dispenser <TP DISP-2>: Jumbo Double roll, surface-mounted, stainless steel unit.
  - 1. Product: Model B-2892 manufactured by Bobrick or Model 5425 by Bradley.
- B. Soap Dispensers: Owner furnished, contractor installed.
- C. Framed Mirrors <MIRROR-10>: Stainless steel framed, 6 mm thick tempered glass mirror.
  - 1. Size: As indicated on drawings.
  - 2. Frame: 0.05 inch (1.3 mm) angle shapes, with mitered and welded and ground corners, and tamperproof hanging system; No.4 finish.
  - 3. Product: 780 Series manufactured by Bradley or equal.
- D. Half-Dome Security Mirrors: 18 inch 3-way domed mirror. Basis of Design Uline or approved equal.
- E. Grab Bars <GRAB BAR-#>: Stainless steel, nonslip grasping surface finish.
  - 1. Standard Duty Grab Bars:
    - a. Push/Pull Point Load: 250 pound-force (1112 N), minimum.
    - b. Dimensions: 1-1/4 inch (32 mm) outside diameter, minimum 0.05 inch (1.3 mm) wall thickness, exposed flange mounting, 1-1/2 inch (38 mm) clearance between wall and inside of grab bar.
    - c. Length and Configuration: As indicated on drawings.
  - 2. Product: 812 Series manufactured by Bradley.
- F. Sanitary Napkin Disposal Unit <NPKN DISP-1>: Stainless steel, surface-mounted, self-closing door, locking bottom panel with full-length stainless steel piano-type hinge, removable receptacle.

- 1. Product: Model B-270 manufactured by Bobrick.
- G. Robe Hook (locker rooms): Stainless steel; rectangular-shaped bracket and backplate, satin finish.
  - 1. Product: Model B-233 by Bradley.
- H. Clothes Hook (pool area): Cast aluminum clothes hook with rubber bumper; matte finish.
  - 1. Product: Model B-212 by Bradley.
- I. Diaper Changing Station: Wall-mounted folding diaper changing station for use in commercial toilet facilities, meeting or exceeding ASTM F2285.
  - 1. Style: Horizontal.
  - 2. Material: Polyethylene.
  - 3. Mounting: Surface.
  - 4. Minimum Rated Load: 250 lbs (113.4 kg).
  - 5. Product: Model KB208 by Koala Kare.

#### 2.05 UTILITY ROOM ACCESSORIES

- A. Combination Utility Shelf/Mop and Broom Holder <MOP HLDR-1>: 0.05 inch (1.3 mm) thick stainless steel, Type 304, with 1/2 inch (12 mm) returned edges, 0.06 inch (1.6 mm) steel wall brackets.
  - 1. Hooks: 4, 0.06 inch (1.6 mm) stainless steel rag hooks at shelf front.
  - 2. Mop/broom holders: 3 spring-loaded rubber cam holders at shelf front.
  - 3. Length: Manufacturer's standard length for number of holders/hooks.
  - 4. Product: Model 9933 manufactured by Bradley.
  - Provide one in each janitor's closet, locations indicated as <MOP HLDR-1>, unless otherwise noted.

#### PART 3 EXECUTION

#### 3.01 EXAMINATION

- A. Verify existing conditions before starting work.
- B. Verify exact location of accessories for installation.
- C. Verify that field measurements are as indicated on drawings.
- D. See Section 06 1000 for installation of blocking, reinforcing plates, and concealed anchors in walls and ceilings.


# 3.02 PREPARATION


- A. Deliver inserts and rough-in frames to site for timely installation.
- B. Provide templates and rough-in measurements as required.

## 3.03 INSTALLATION

- A. Install accessories in accordance with manufacturers' instructions in locations indicated on the drawings.
- B. Install plumb and level, securely and rigidly anchored to substrate.

C. Mounting Heights: As required by accessibility regulations, unless otherwise indicated. **END OF SECTION** 

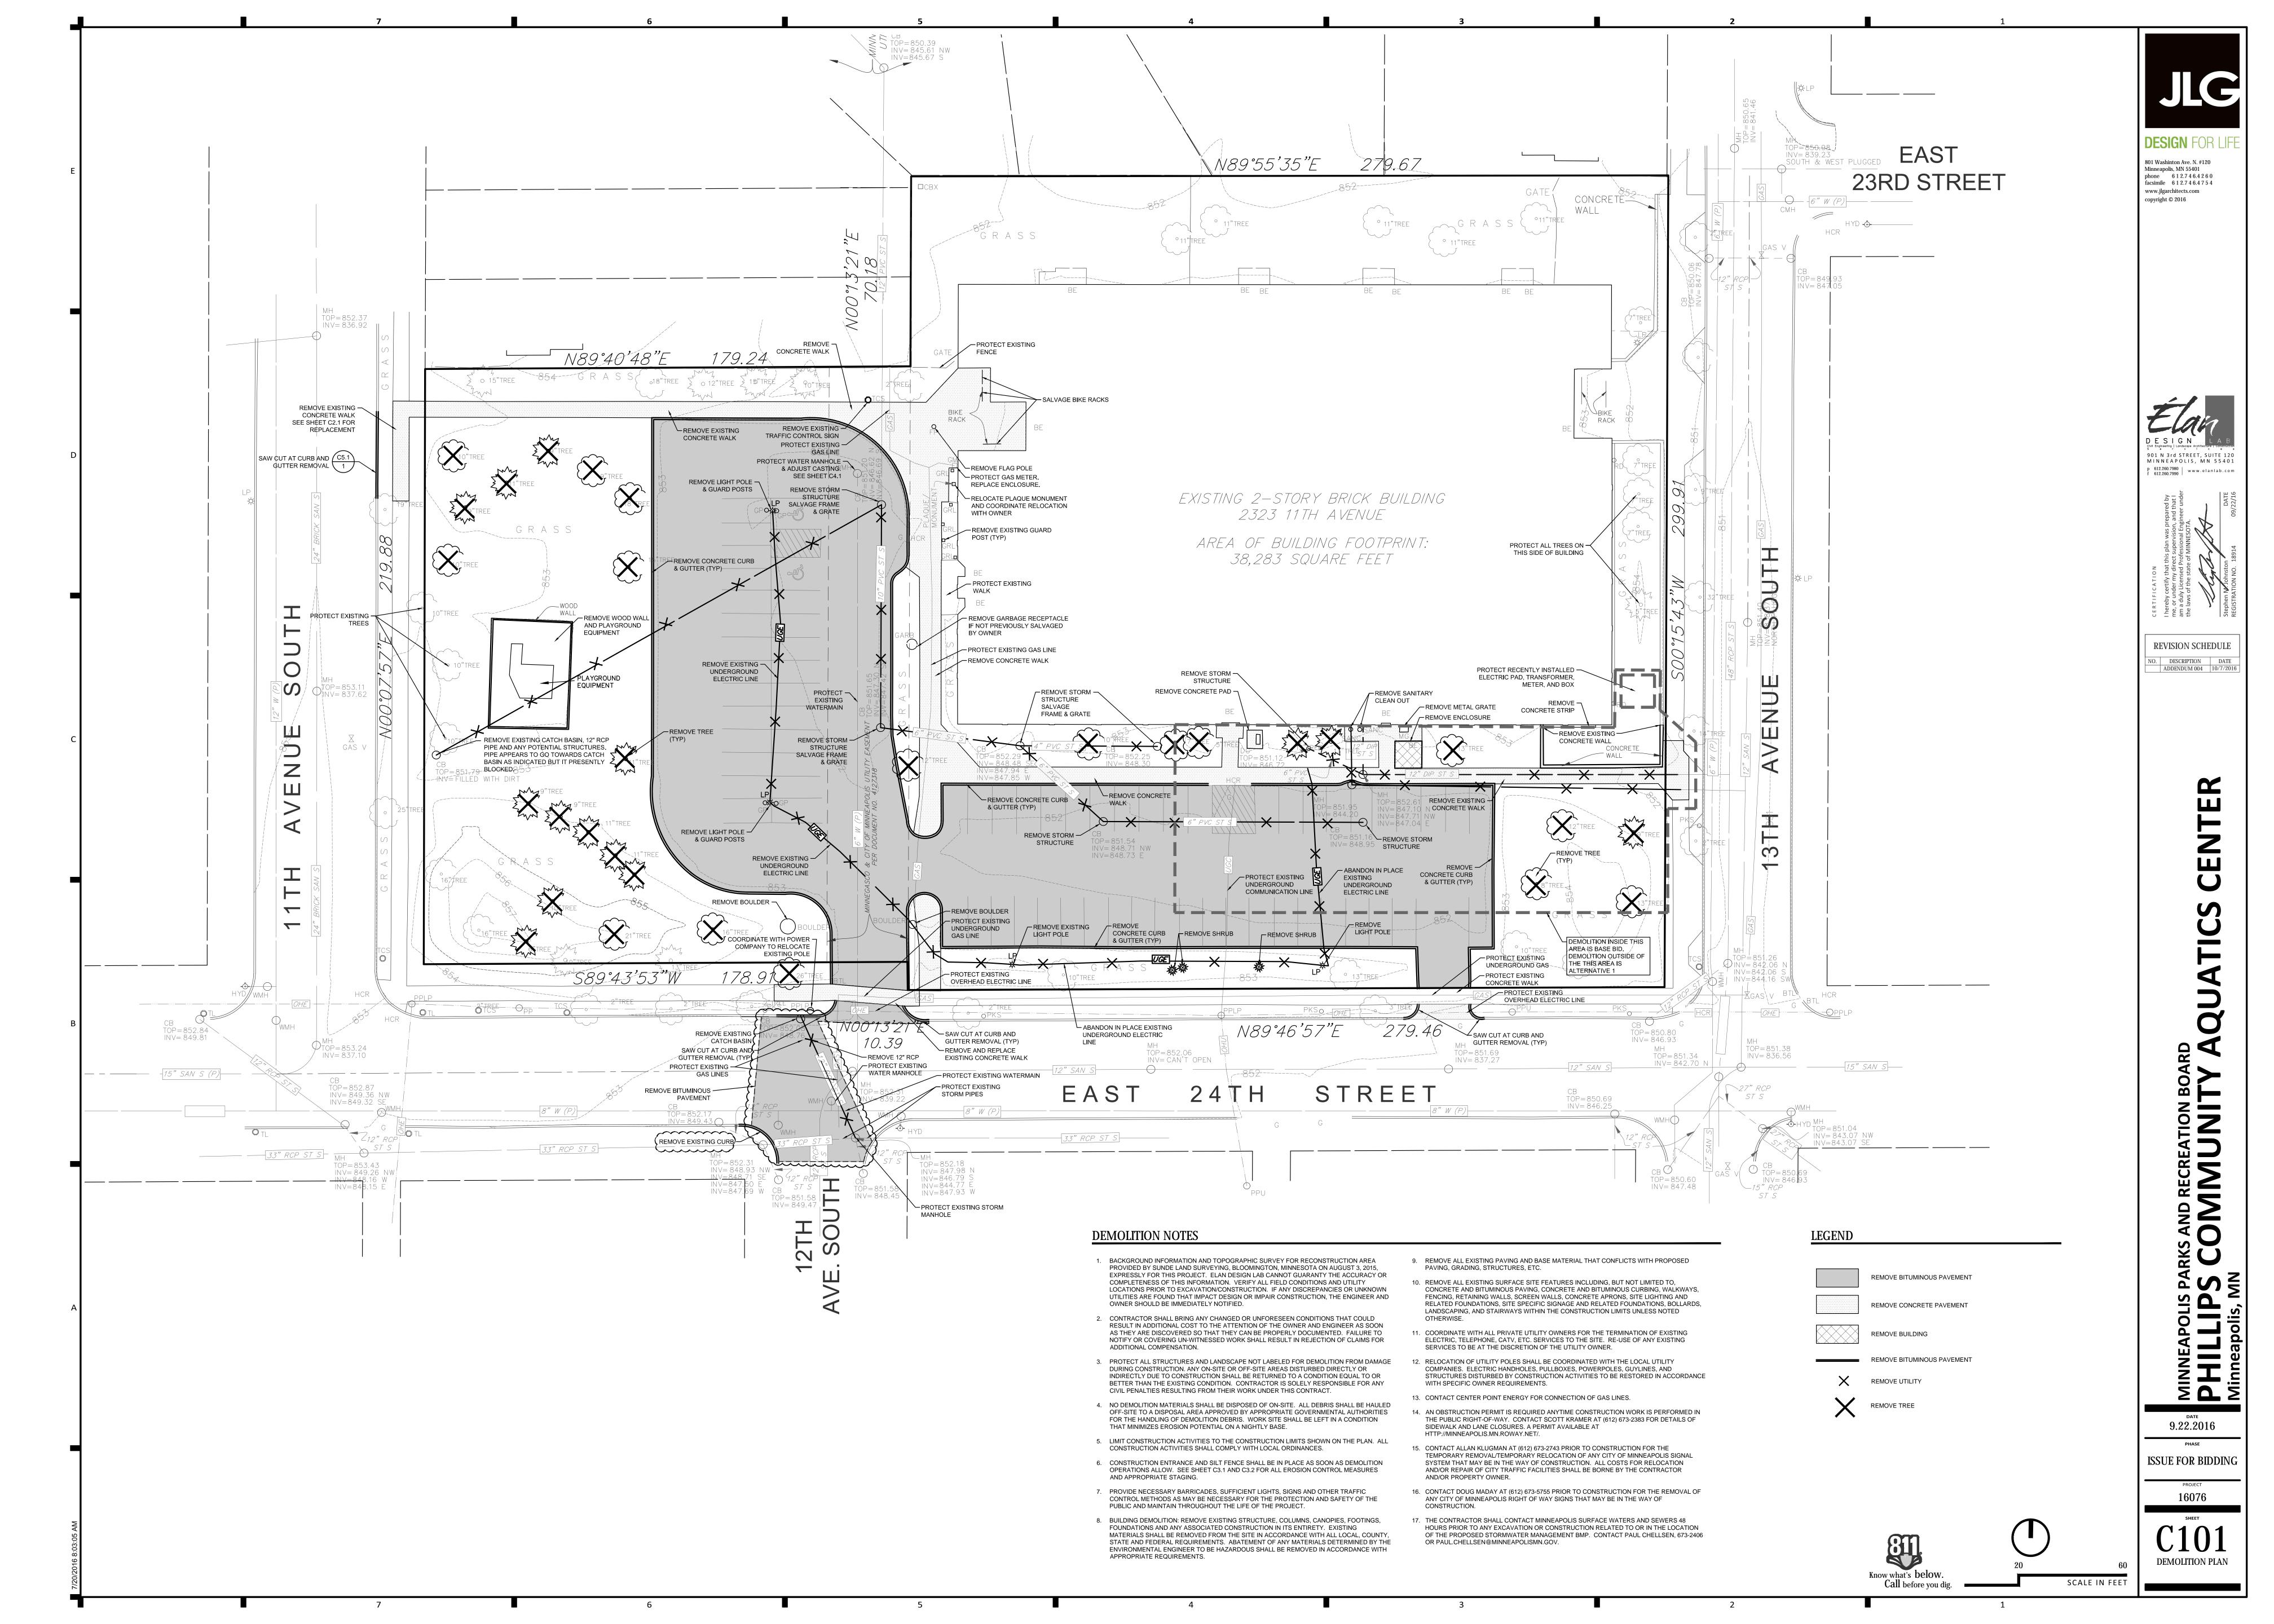

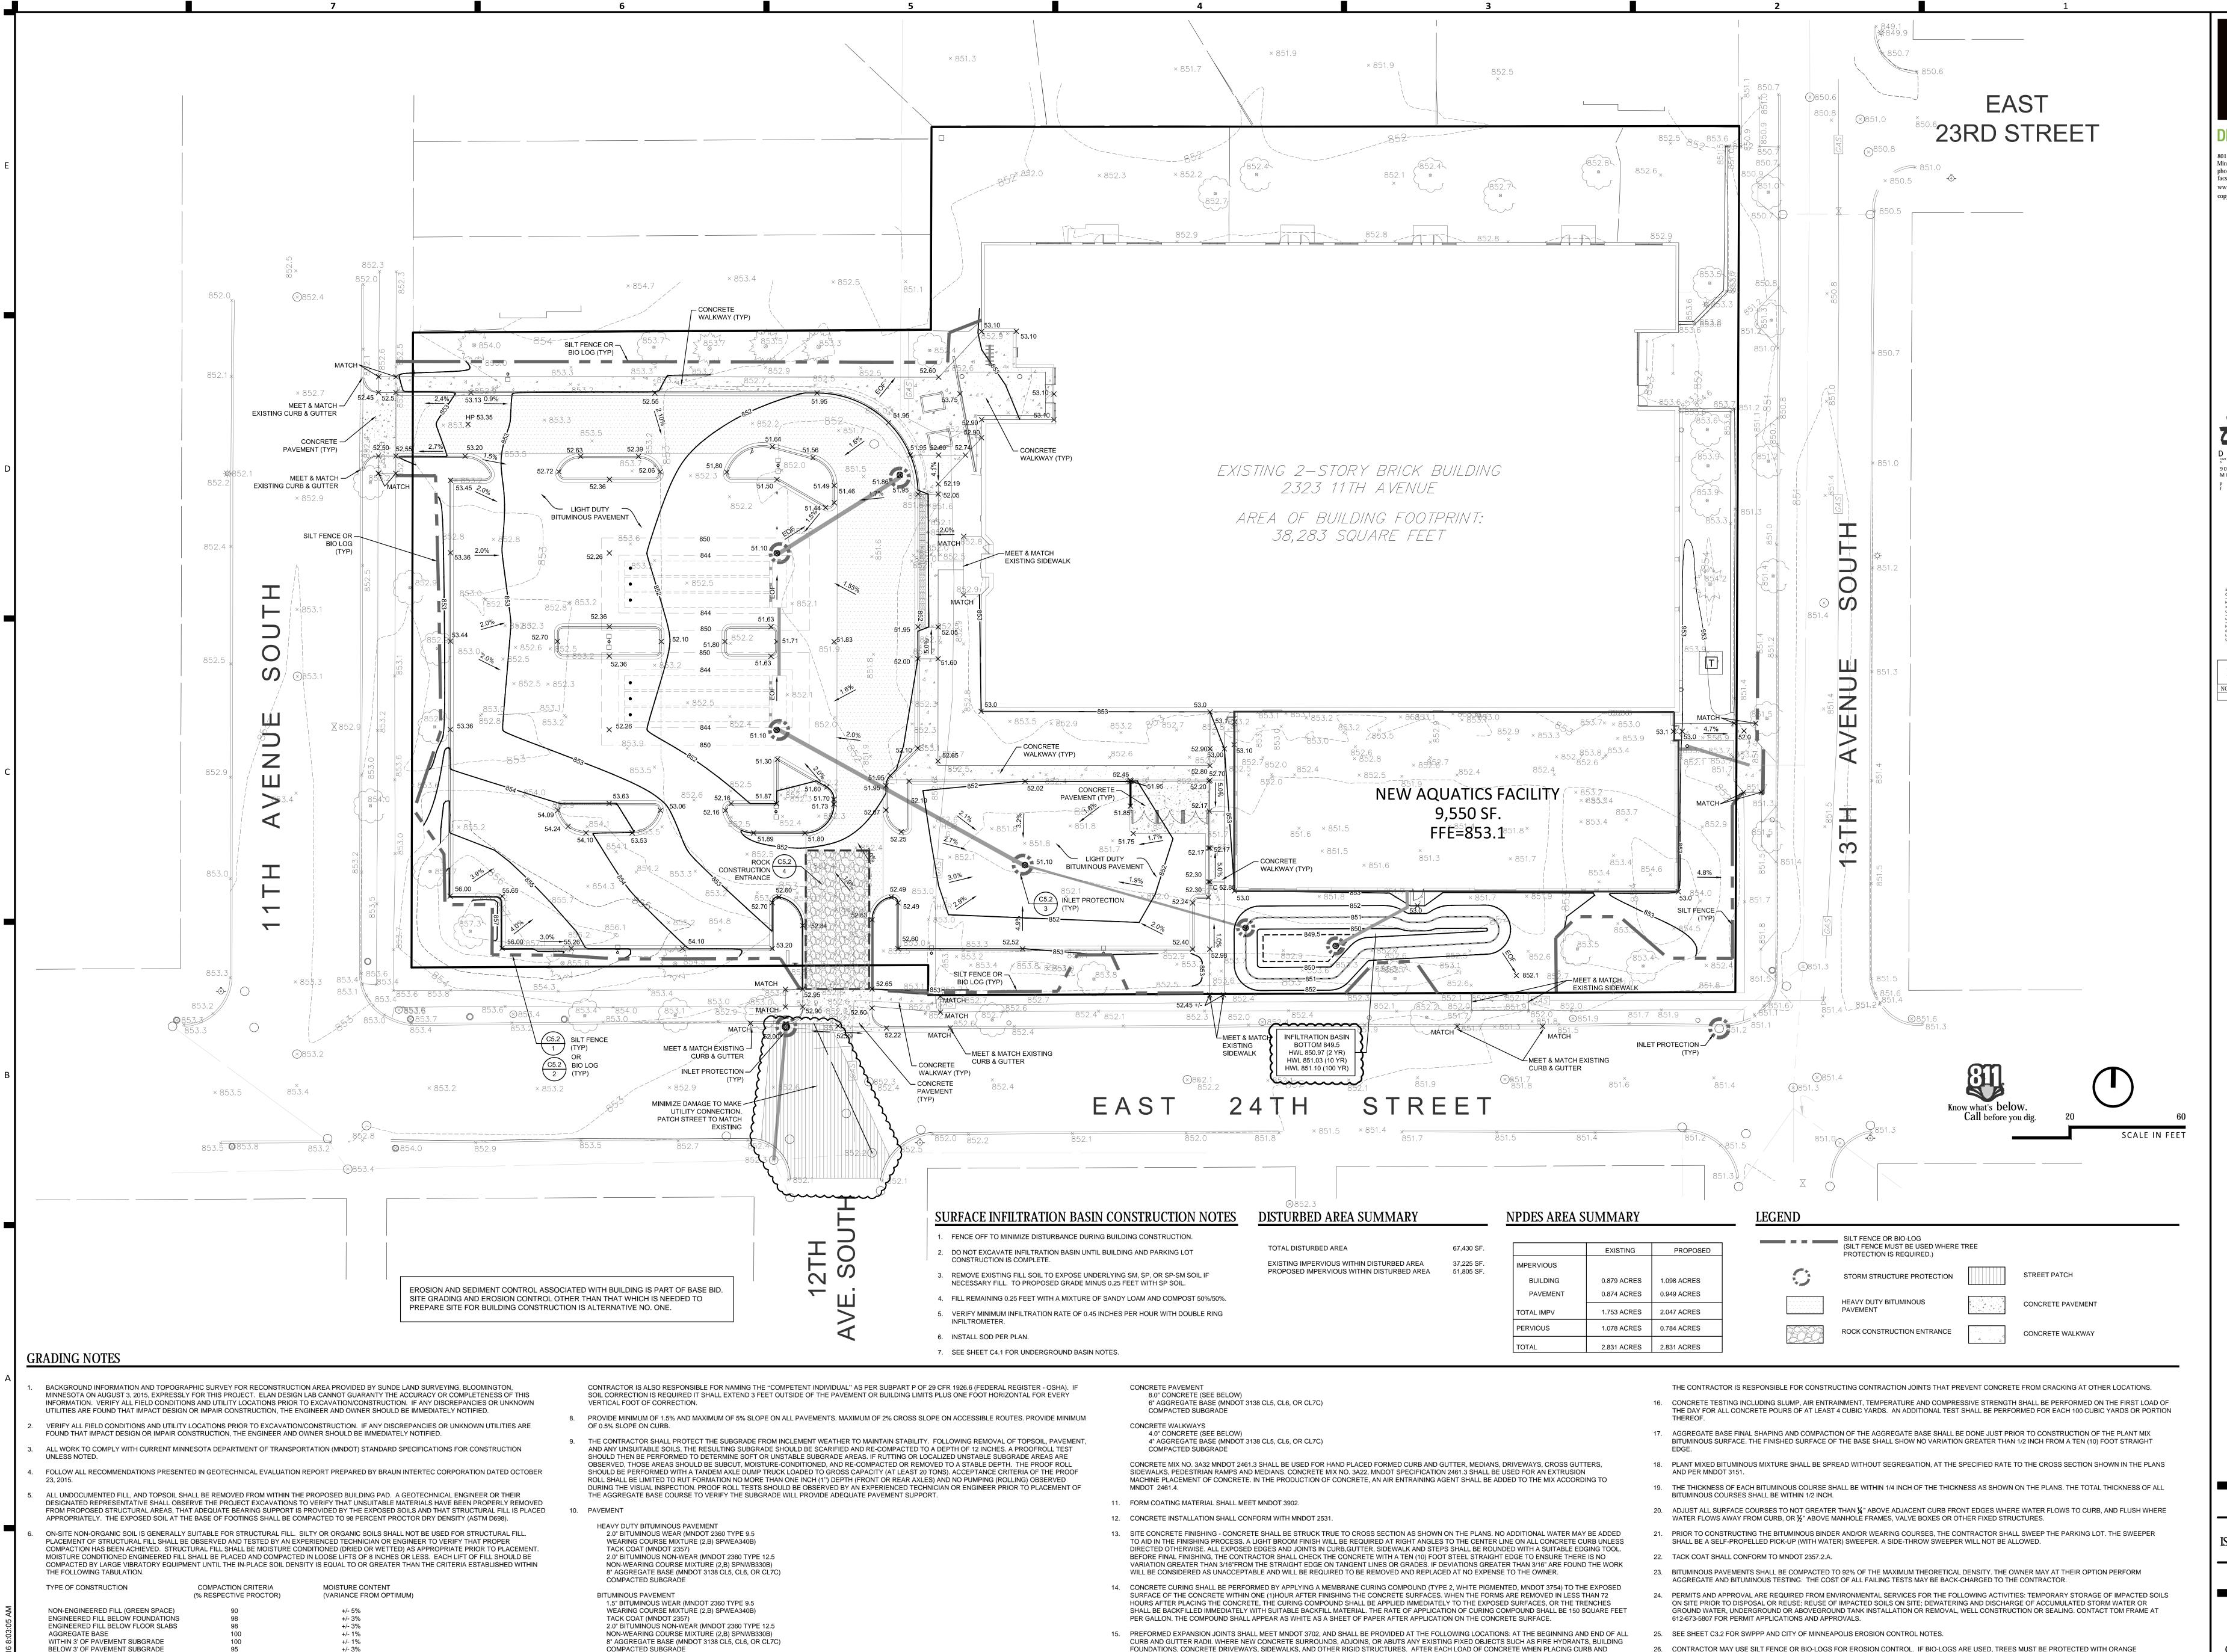

SIDEWALLS SHALL BE BENCHED OR SLOPED TO PROVIDE SAFE WORKING CONDITIONS AND STABILITY FOR ENGINEERED FILL PLACEMENT. THE


CONTRACTOR IS SOLELY RESPONSIBLE FOR ASSESSING THE STABILITY OF AND EXECUTING PROJECT EXCAVATIONS USING SAFE METHODS. THE

EVERY 100 FEET WHEN PLACING SIDEWALK. CONTRACTION JOINTS WILL NOT BE SEALED BUT WILL BE REQUIRED AT A SPACING OF 10 FEET ON CURB AND

GUTTER AND ON SIDEWALK CONSTRUCTION AS SHOWN ON THE PLAN. CONTRACTION JOINTS WILL BE CUT TO A DEPTH 1/3 THE THICKNESS OF THE CONCRETE, SURFACE AND BACK OF ALL CURBS. CONTRACTION JOINTS SHALL BE PLACED SO THAT NO SLAB IS LARGER THAN 100 SQUARE FEET IN AREA. SAFETY FENCE AT DRIP LINE OR CONSTRUCTION LIMITS.

801 Washinton Ave. N. #120 Minneapolis, MN 55401 phone 6 1 2.7 4 6.4 2 6 0 facsimile 6 1 2.7 4 6.4 7 5 4 www.jlgarchitects.com opyright © 2016



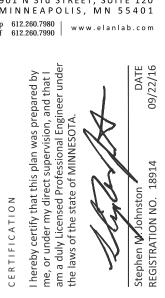


**REVISION SCHEDULE** ADDENDUM 004 10/7/201

9.22.2016


**ISSUE FOR BIDDING** 

CONTROL PLAN

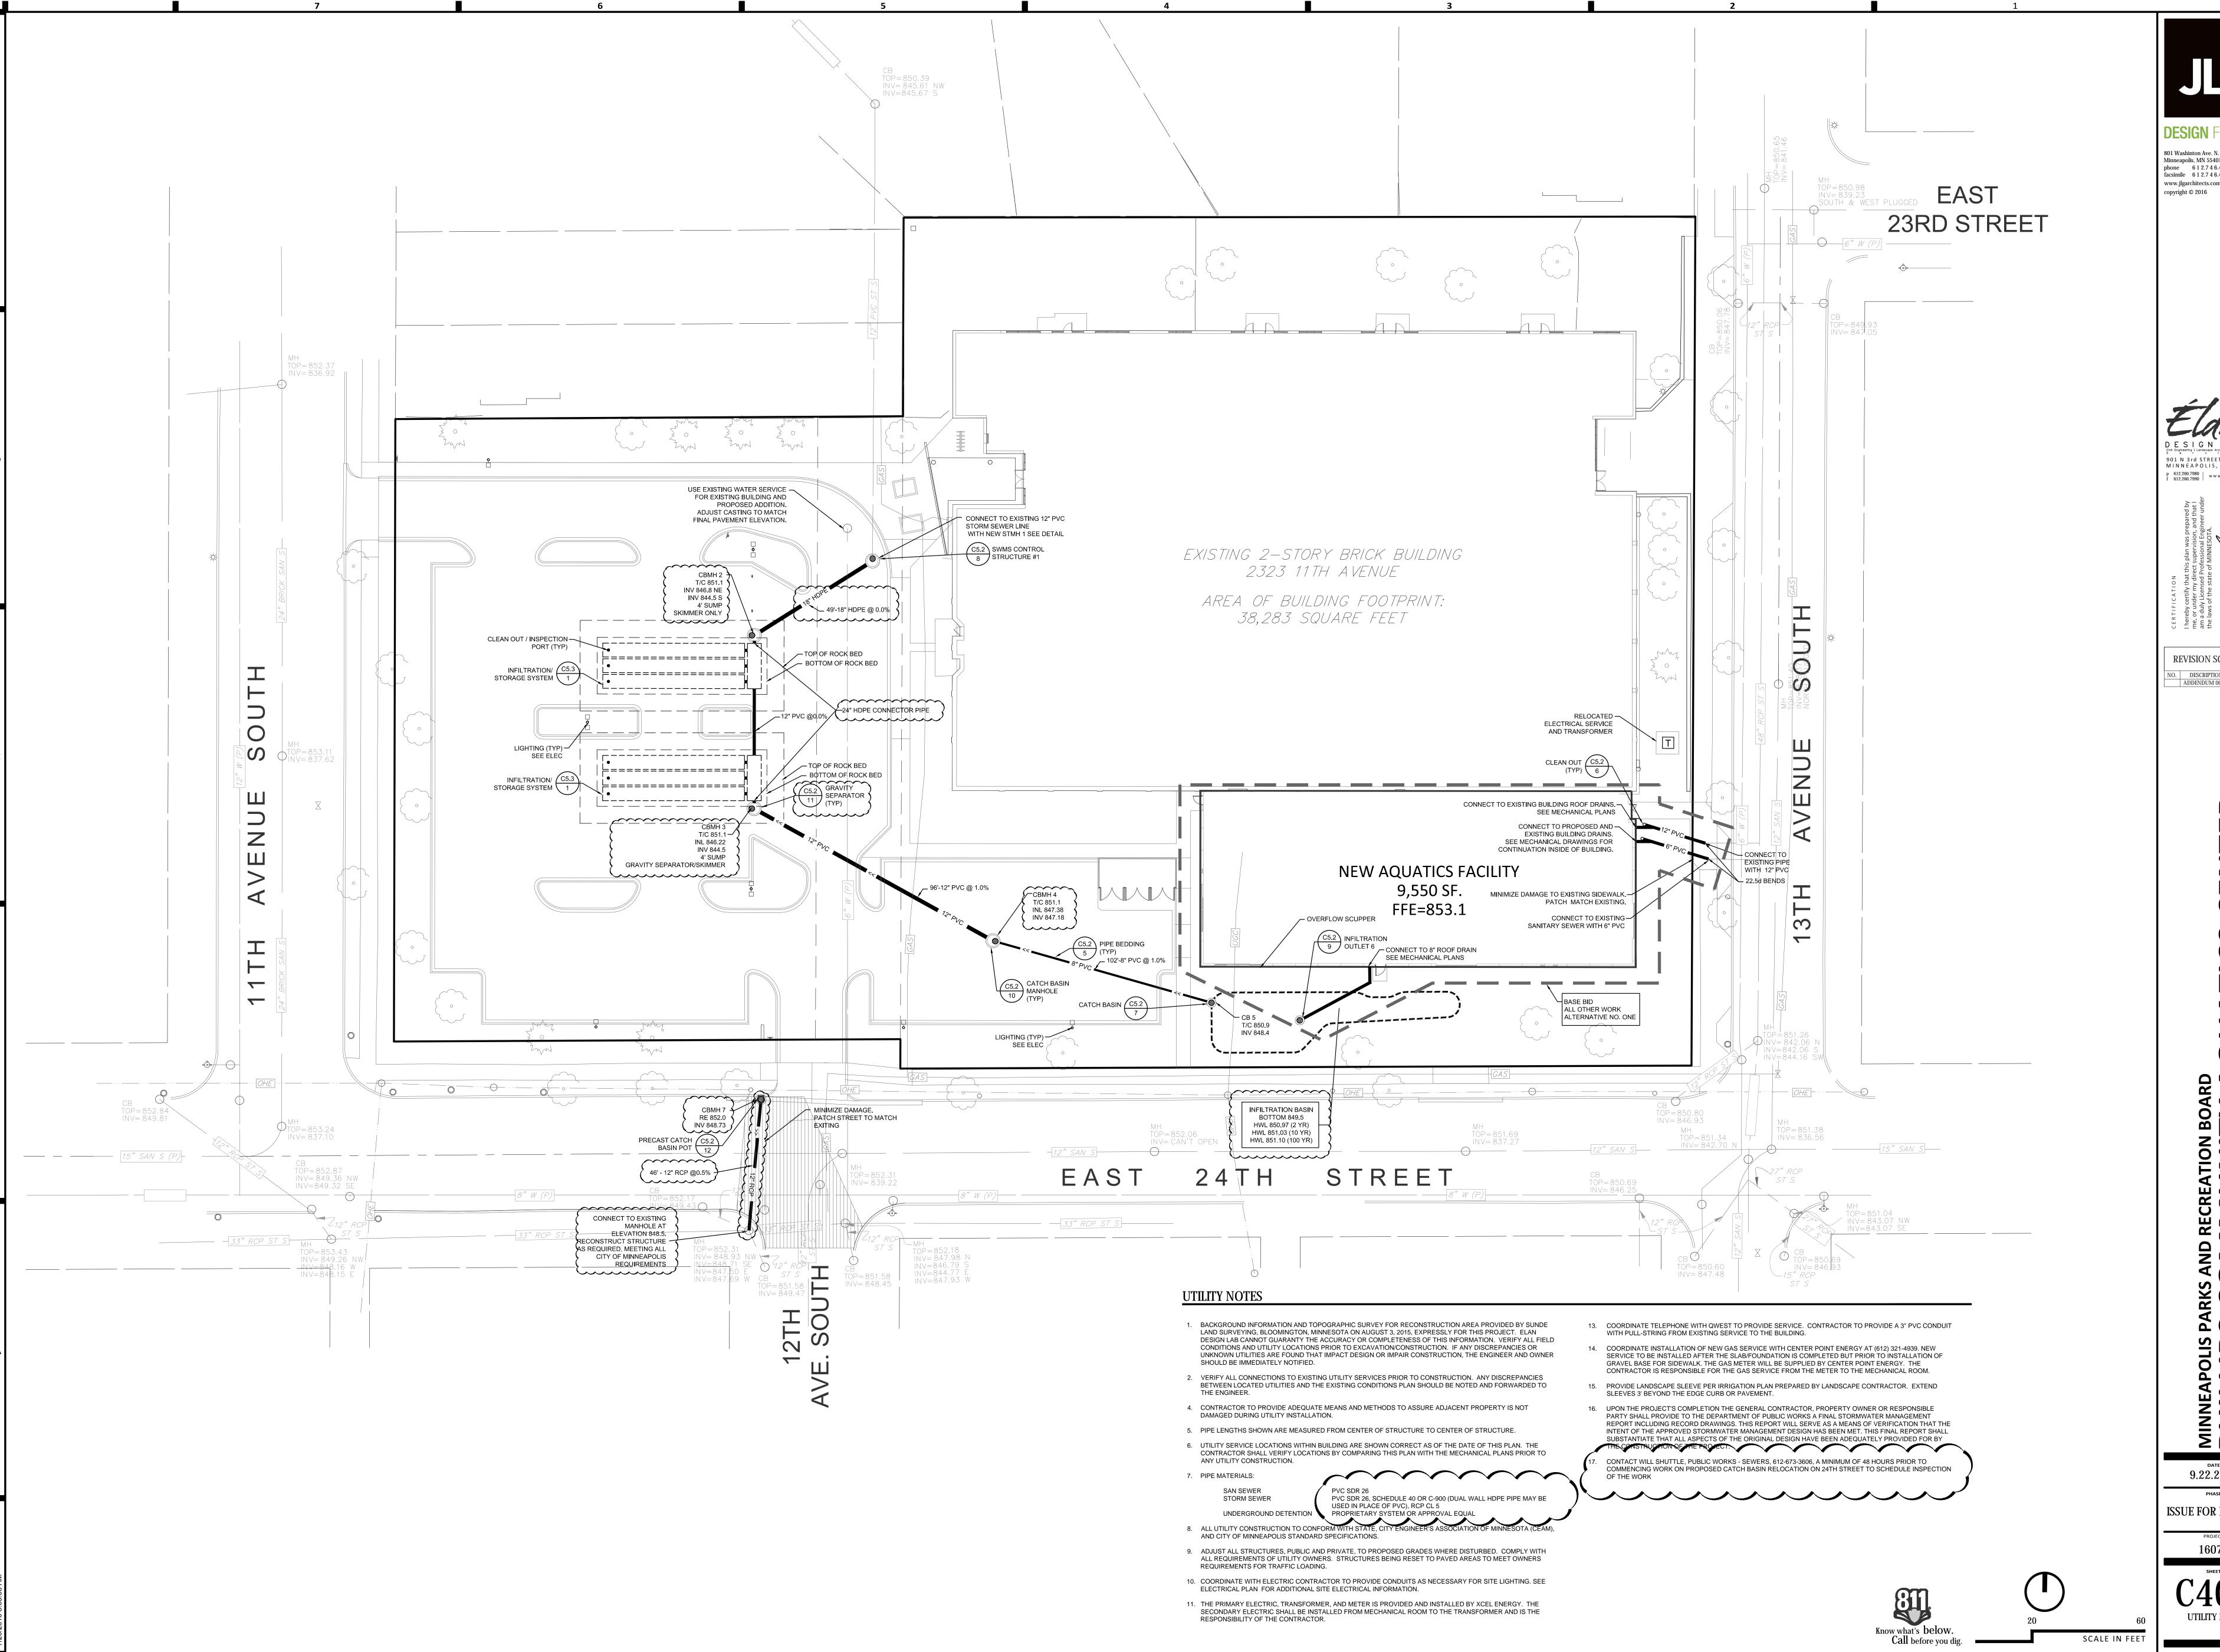

801 Washinton Ave. N. #120 Minneapolis, MN 55401 phone 6 1 2.7 4 6.4 2 6 0 facsimile 6 1 2.7 4 6.4 7 5 4 www.jlgarchitects.com




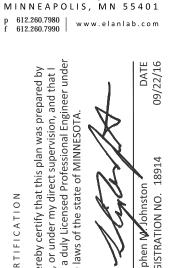

REVISION SCHEDULE ADDENDUM 004 10/7/2016

9.22.2016

**ISSUE FOR BIDDING** 

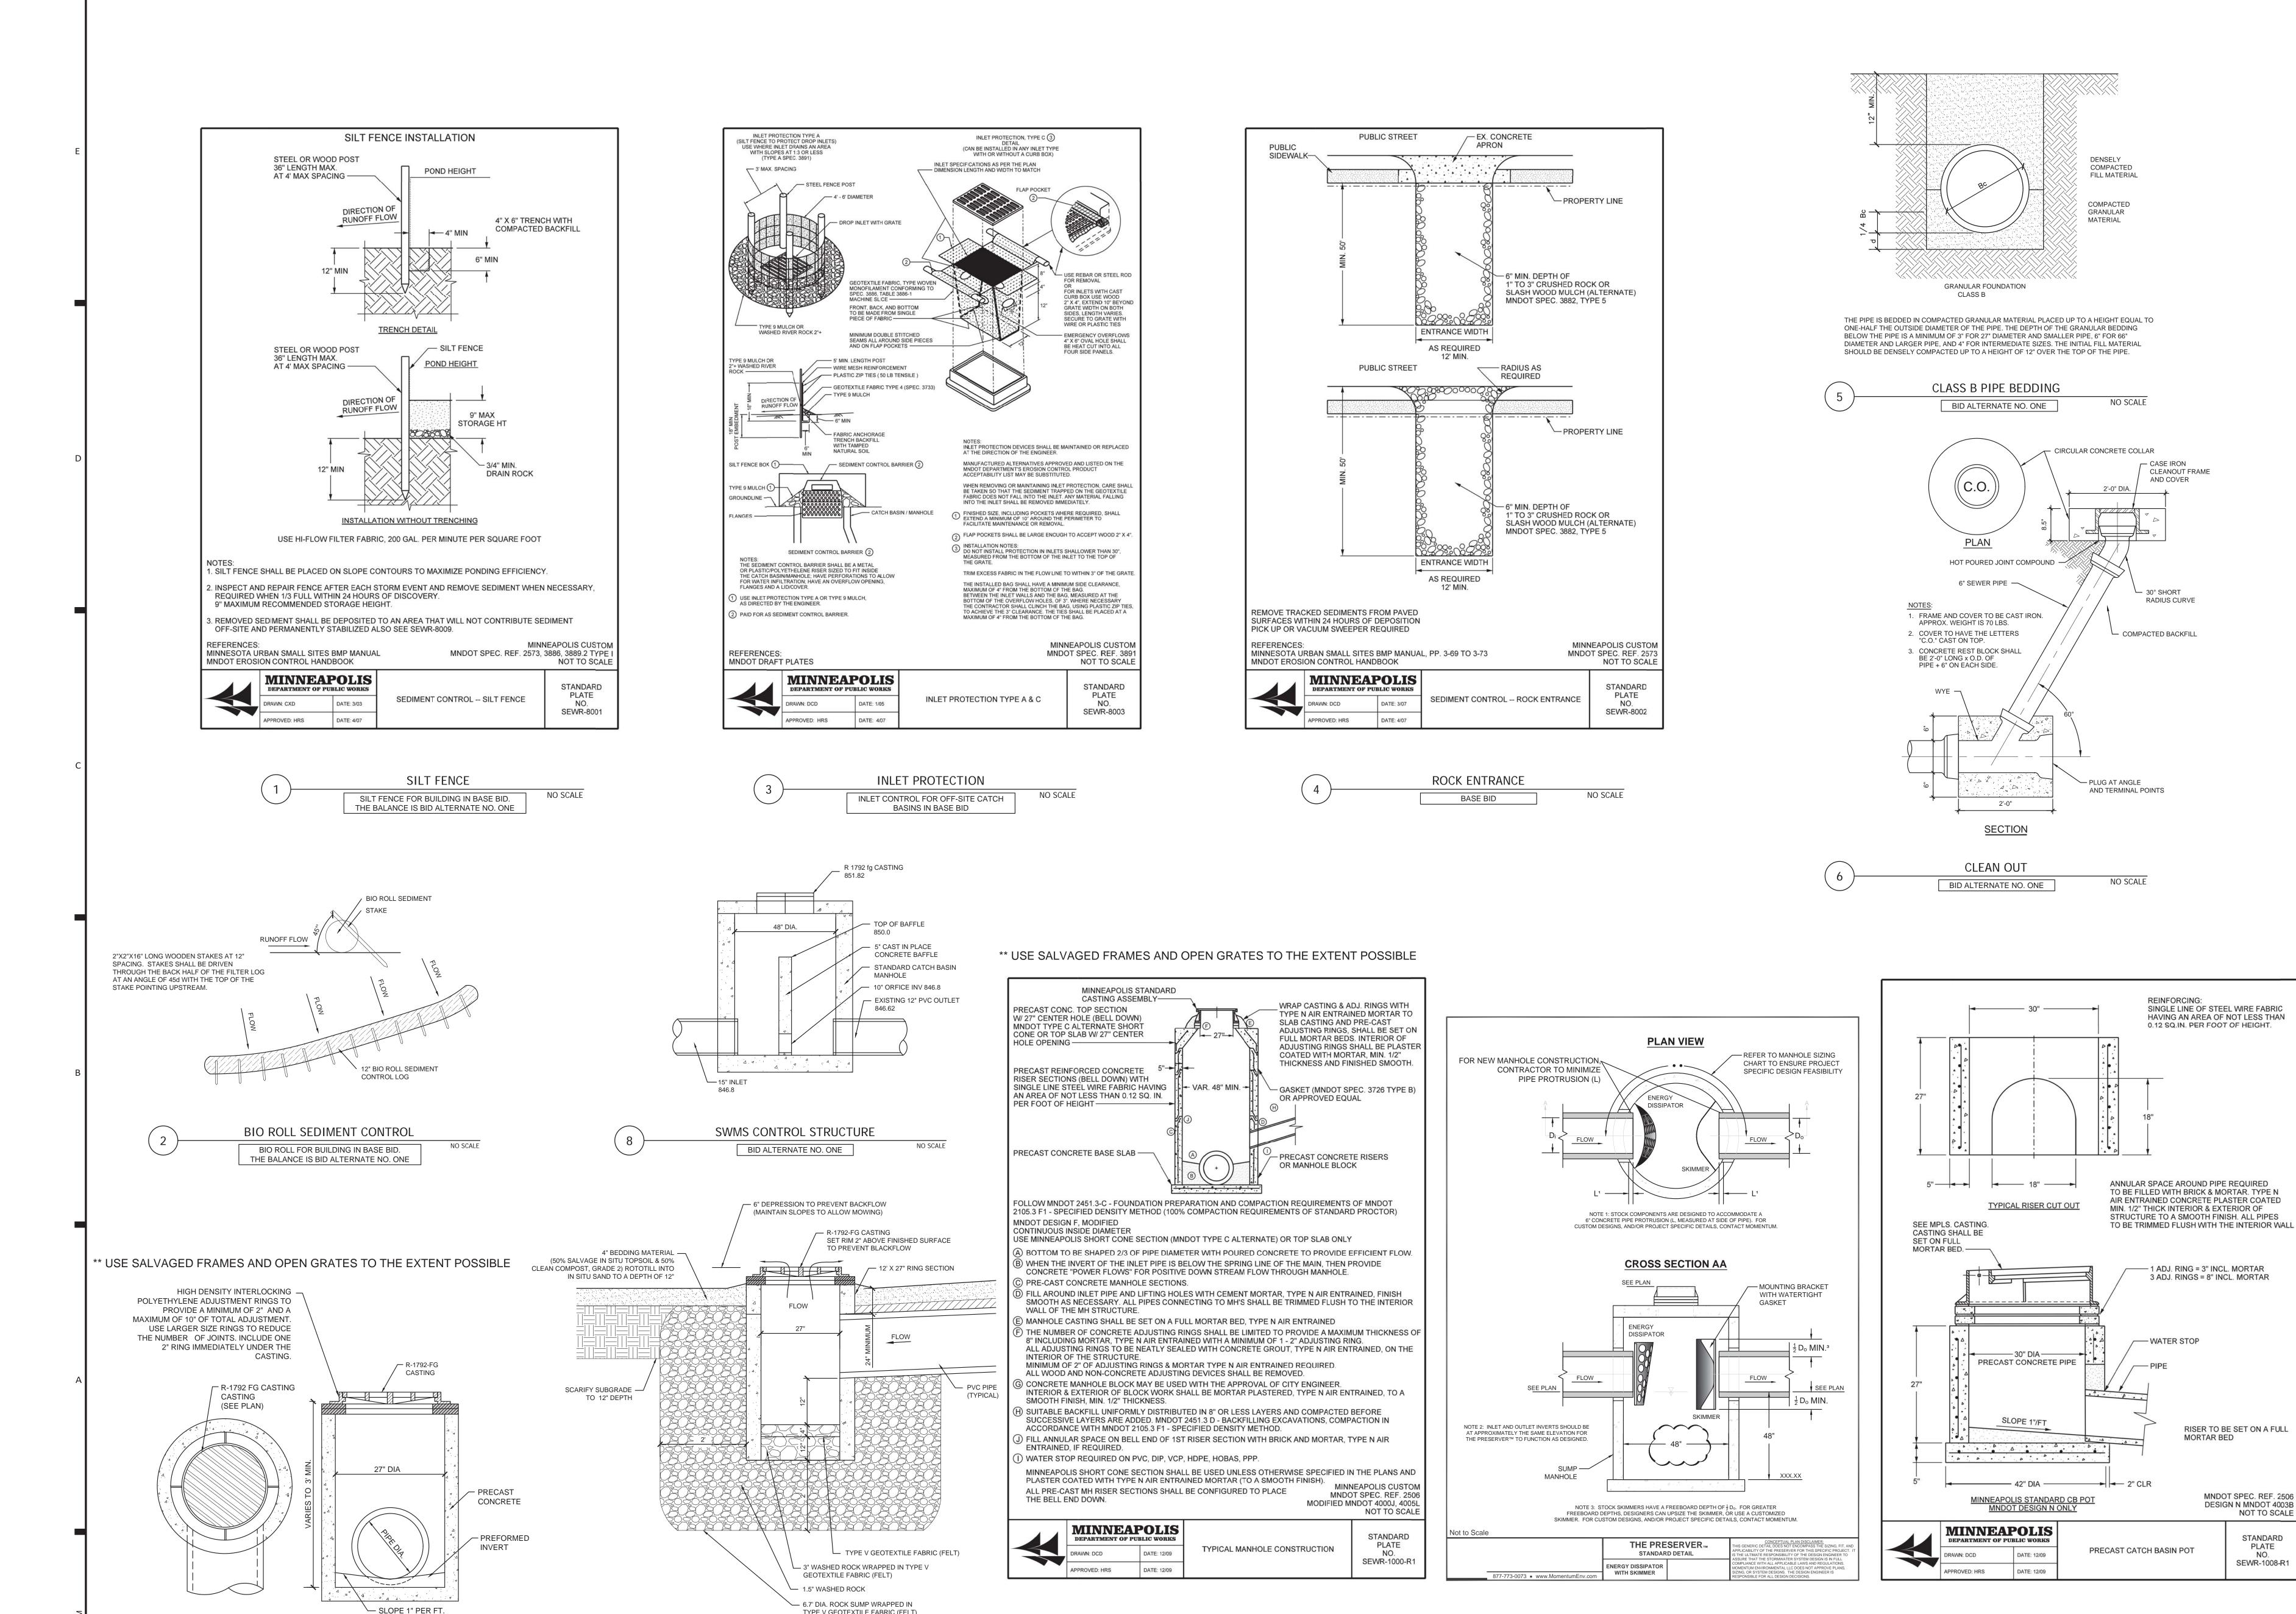

MANHOLE CONSTRUCTION

BID ALTERNATE NO. ONE

NO SCALE

10

**GRAVITY SEPARATOR** 

BID ALTERNATE NO. ONE

(OTHER SYSTEMS PROVIDING SAME FUNCTIONALITY MAY BE USED) NO SCALE

TYPE V GEOTEXTILE FABRIC (FELT)

NO SCALE

INFILTRATION OUTLET

27" CATCH BASIN

BID ALTERNATE NO. ONE

NO SCALE

801 Washinton Ave. N. #120 Minneapolis, MN 55401 phone 6 1 2.7 4 6.4 2 6 0 facsimile 6 1 2.7 4 6.4 7 5 4 www.jlgarchitects.com copyright © 2016

MINNEAPOLIS, MN 55401

612.260.7980 | www.elanlab.com

ADDENDUM 004 10/7/2016

**REVISION SCHEDULE** NO. DESCRIPTION DATE

9.22.2016

ISSUE FOR BIDDING 16076

**DETAILS** 


PRECAST CATCH BASIN POT

BID ALTERNATE NO. ONE

NO SCALE






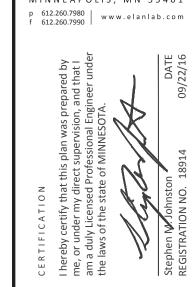


NO. DESCRIPTION DATE ADDENDUM 004 10/7/2016


Ш

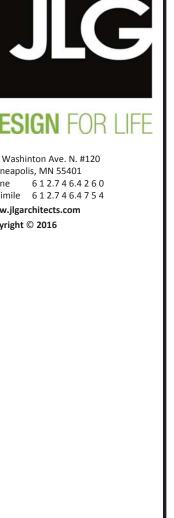






REVISION SCHEDULE

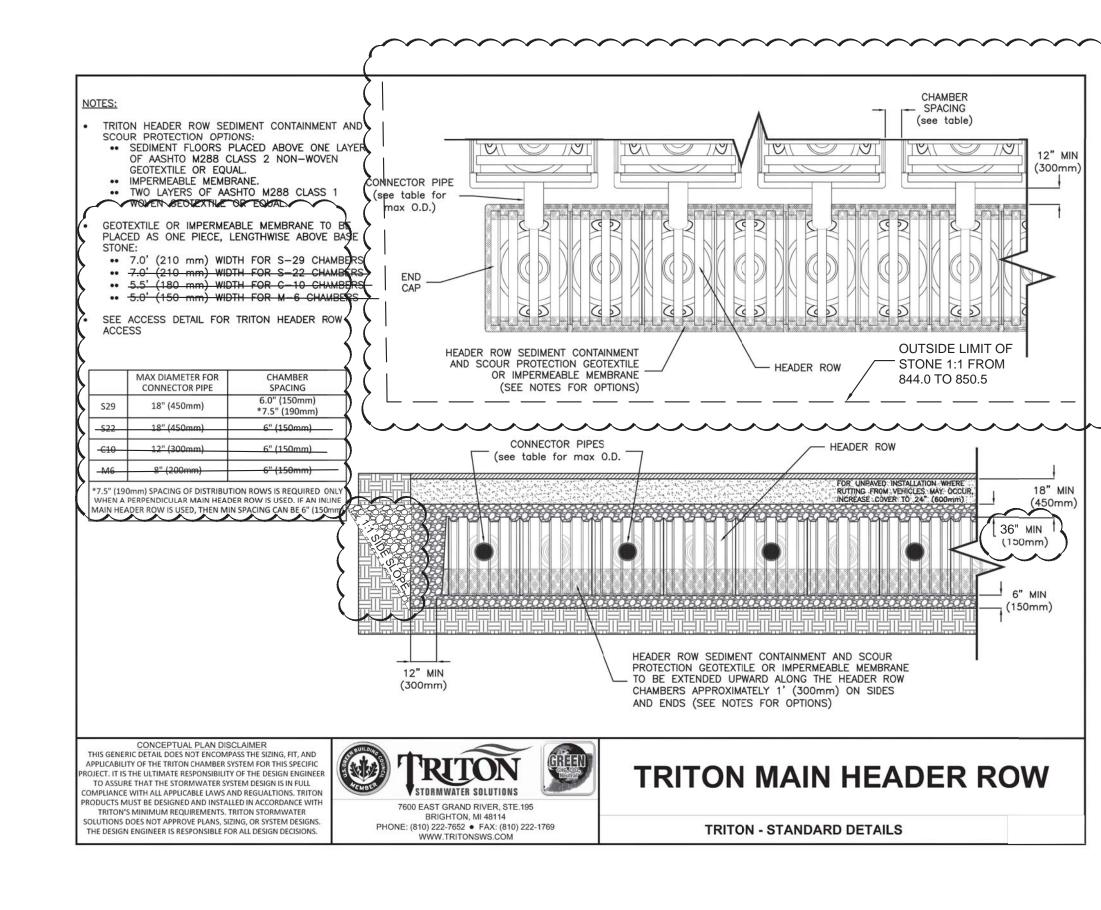


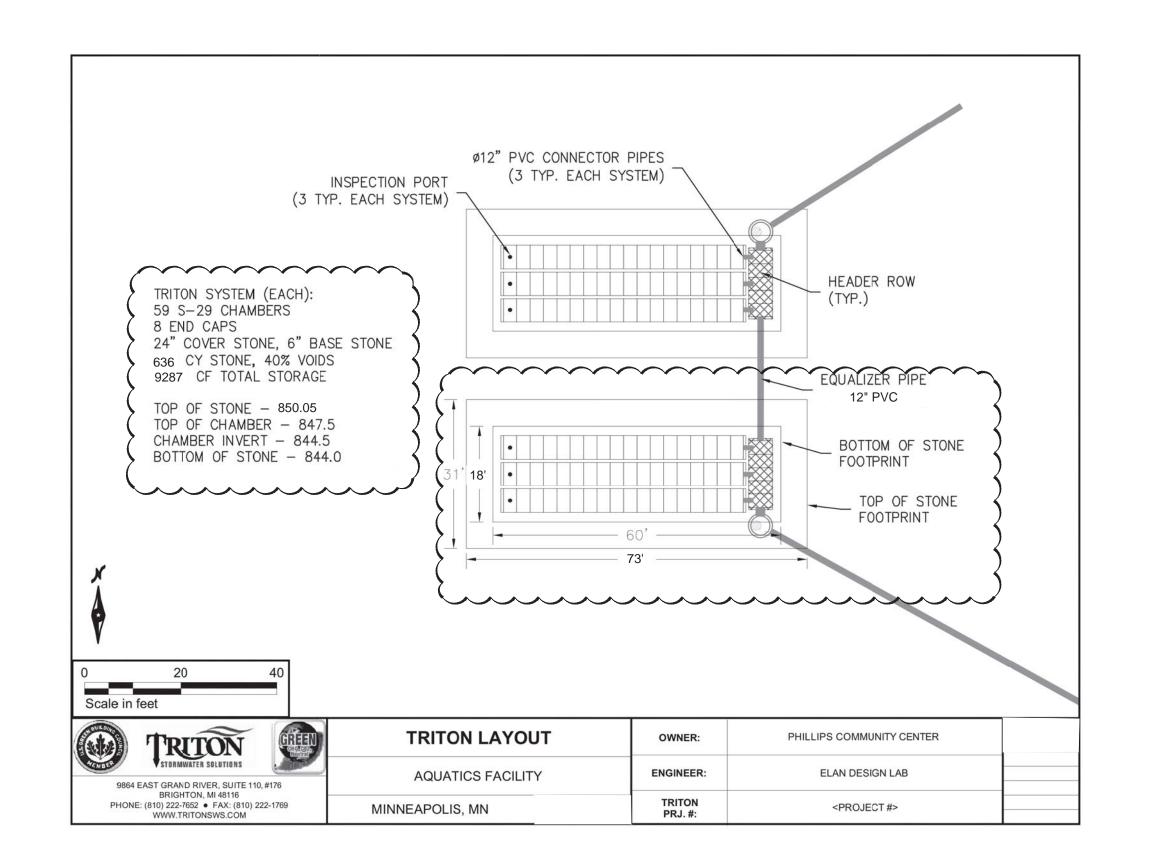

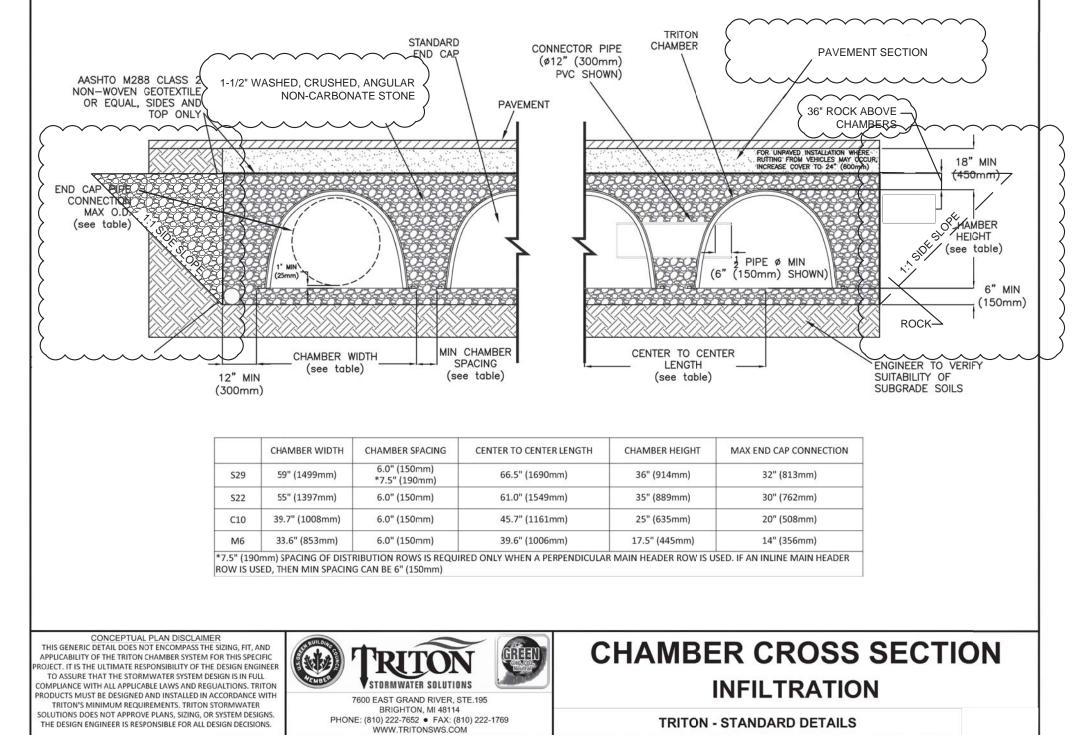

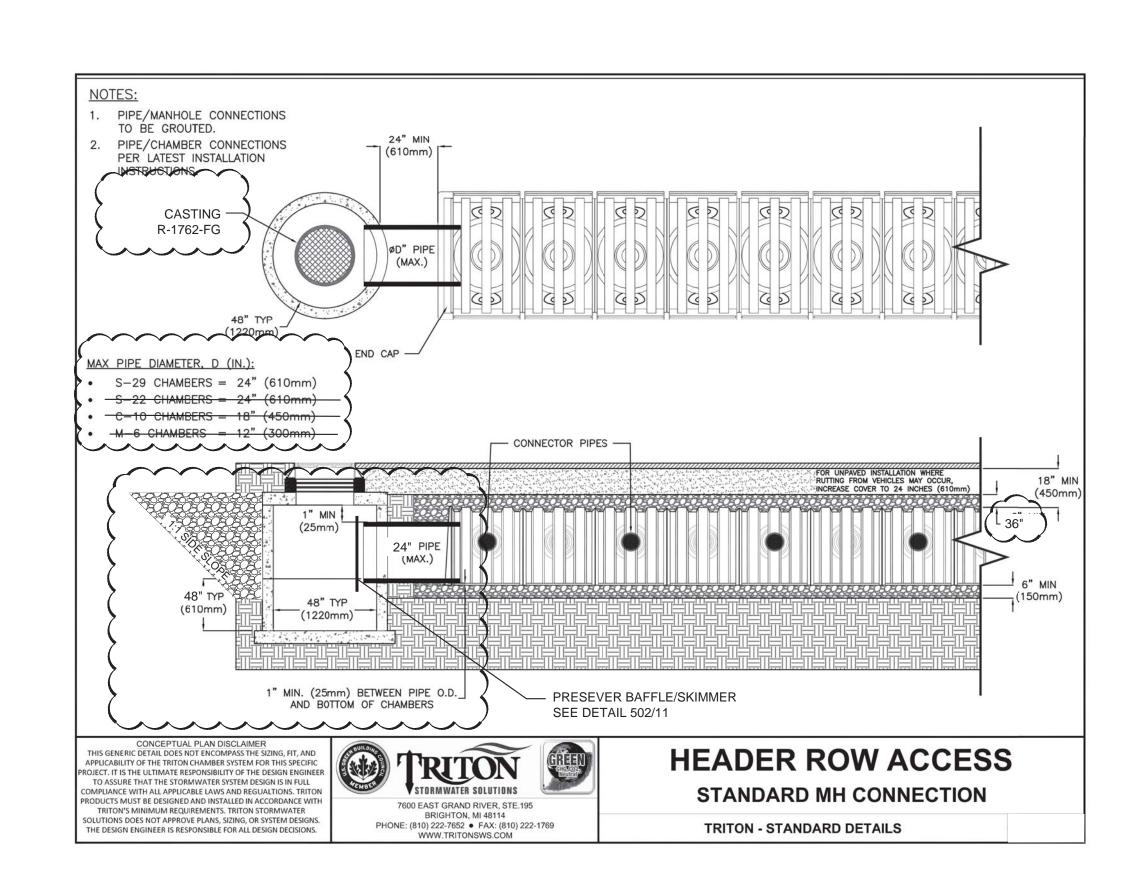

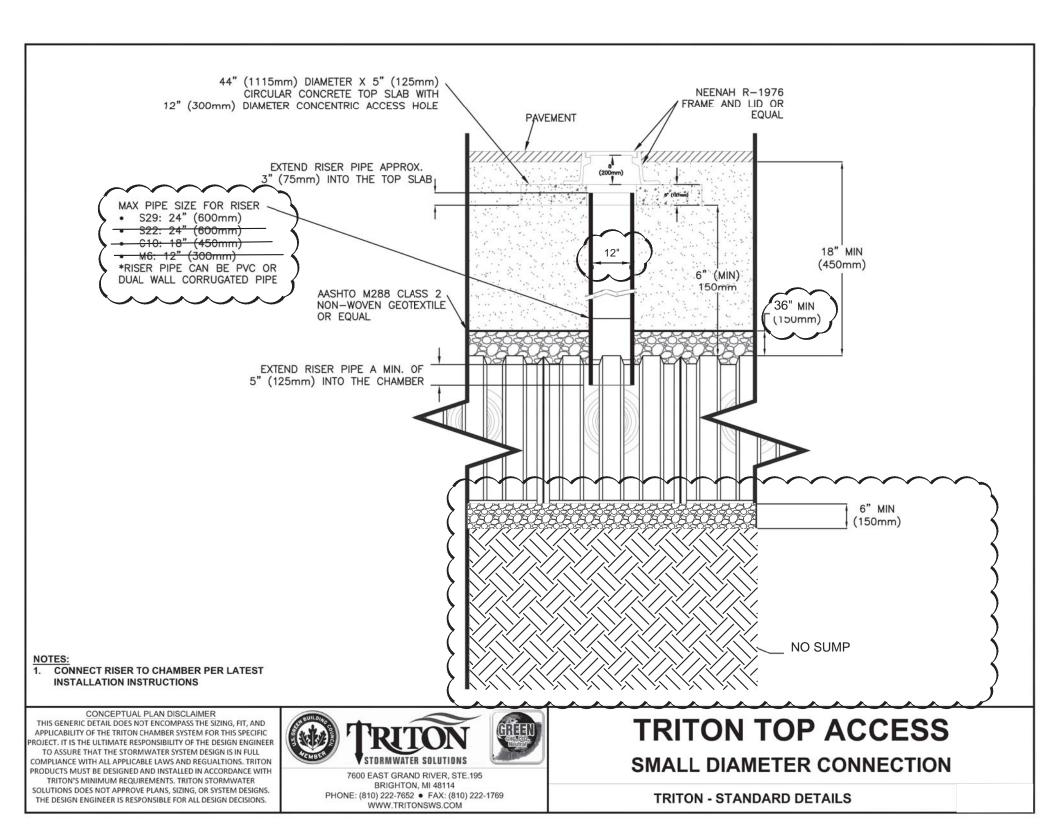

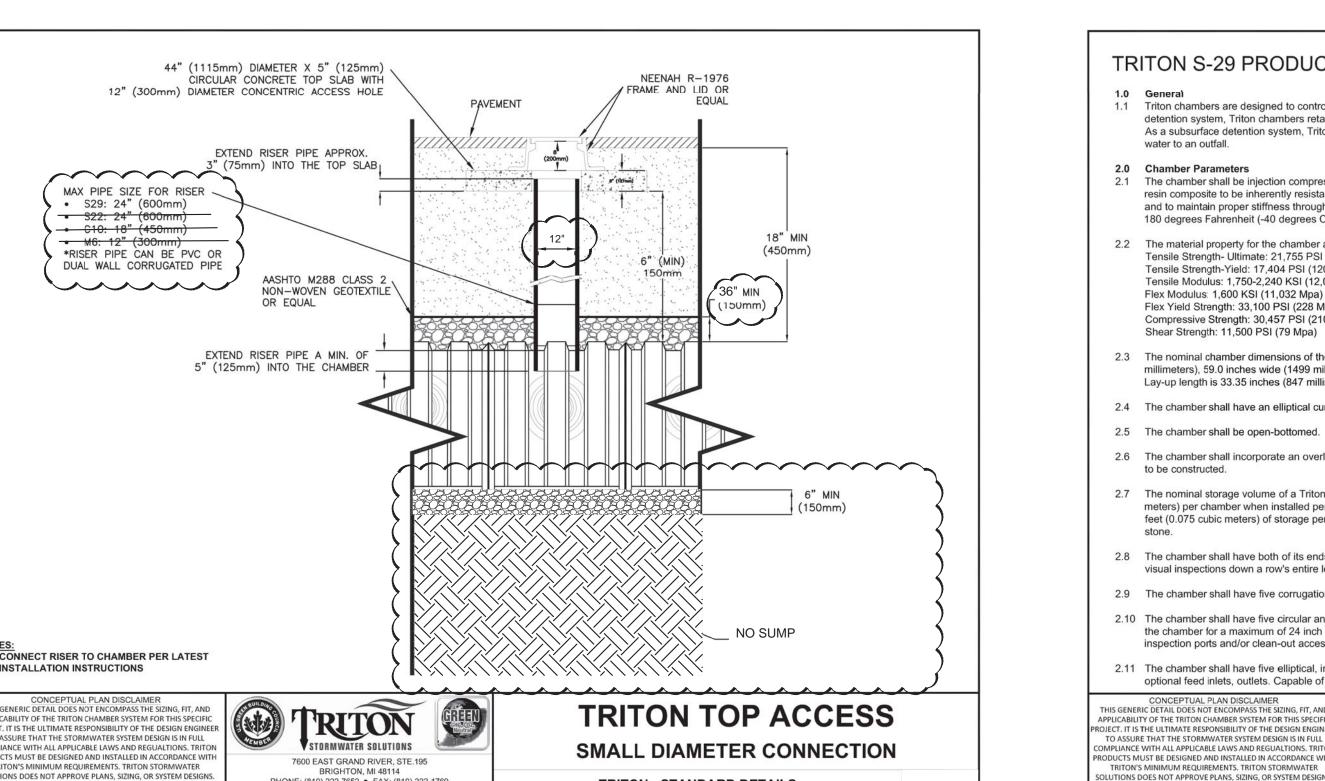

# TRITON S-29 PRODUCT SPECIFICATIONS

- 1.1 Triton chambers are designed to control stormwater runoff. As a subsurface retention or detention system, Triton chambers retain and allow effective infiltration of water into the soil. As a subsurface detention system, Triton chambers detain and allow for the metered flow of
- 2.1 The chamber shall be injection compression molded of a structural grade 1010 green soy resin composite to be inherently resistant to environmental stress cracking (ESCR), creep, and to maintain proper stiffness through temperature ranges of -40 degrees Fahrenheit to 180 degrees Fahrenheit (-40 degrees Celsius to 82.2 degrees Celsius).
- 2.2 The material property for the chamber and end cap must meet or exceed the following: Tensile Strength- Ultimate: 21,755 PSI (150 Mpa) Tensile Strength-Yield: 17,404 PSI (120 Mpa) Tensile Modulus: 1,750-2,240 KSI (12,066 Mpa - 15,444 Mpa) Flex Modulus: 1,600 KSI (11,032 Mpa) Flex Yield Strength: 33,100 PSI (228 Mpa) Compressive Strength: 30,457 PSI (210 Mpa)
- 2.3 The nominal chamber dimensions of the Triton S-29 shall be 36.0 inches tall (914 millimeters), 59.0 inches wide (1499 millimeters) and 35.36 inches long (898 millimeters).
- Lay-up length is 33.35 inches (847 millimeters). 2.4 The chamber shall have an elliptical curved section profile.
- 2.5 The chamber shall be open-bottomed.
- 2.6 The chamber shall incorporate an overlapping corrugation joint system to allow chamber rows
- 2.7 The nominal storage volume of a Triton S-29 chamber shall be 41.05 cubic feet (1.162 cubic meters) per chamber when installed per Triton's typical details. This equates to 2.67 cubic feet (0.075 cubic meters) of storage per square foot of bed. This does not include perimeter
- 2.8 The chamber shall have both of its ends open to allow for unimpeded hydraulic flows and visual inspections down a row's entire length.
- 2.9 The chamber shall have five corrugations to achieve strengths defined above.
- 2.10 The chamber shall have five circular and elliptical, indented and raised, surfaces on the top to the chamber for a maximum of 24 inch (610 millimeter) diameter optional top feed inlets, inspection ports and/or clean-out access ports.
- 2.11 The chamber shall have five elliptical, indented, surfaces on either side of the chamber for optional feed inlets, outlets. Capable of accepting pipe O.D. up to 18 inches (450 millimeters).
- CONCEPTUAL PLAN DISCLAIMER
  THIS GENERIC DETAIL DOES NOT ENCOMPASS THE SIZING, FIT, AND PPLICABILITY OF THE TRITON CHAMBER SYSTEM FOR THIS SPECIFIC DIECT. IT IS THE ULTIMATE RESPONSIBILITY OF THE DESIGN ENGINEE TO ASSURE THAT THE STORMWATER SYSTEM DESIGN IS IN FUL DUCTS MUST BE DESIGNED AND INSTALLED IN ACCORDANCE WIT 7600 EAST GRAND RIVER, STE.195 TRITON'S MINIMUM REQUIREMENTS. TRITON STORMWATER OLUTIONS DOES NOT APPROVE PLANS, SIZING, OR SYSTEM DESIGN: PHONE: (810) 222-7652 • FAX: (810) 222-1769 WWW.TRITONSWS.COM THE DESIGN ENGINEER IS RESPONSIBLE FOR ALL DESIGN DECISIONS

- 2.12 The chamber shall be analyzed, designed and field tested using AASHTO LRFD bridge design specifications 1. Design live load shall meet or exceed the AASHTO HS30 or a rear axle load of 48,000 pounds (21,772.4 kg). Design shall consider earth and live loads without pavement as appropriate for the minimum 18 inches (457 millimeters) of total cover to a maximum total cover of 50 feet (15.24 meters).
- 2.13 The chamber shall be manufactured in an ISO 9001:2008 certified facility
- 2.14 The service life of the product is over 60 years under a constant sustained load of 10,000 PSI (68.95 Mpa) which is equal to the H-20 loading condition. Under typical loading conditions the Chamber and End Cap has a useful life span of 120 years from date of when manufactured.
- 3.0 End Cap Parameters 3.1 The end cap shall be Injection Compression molded of 1010 green soy resin to be inherently resistant to environmental stress cracking (ESCR), creep and to maintain proper stiffness
- through temperature ranges of -40 degrees Fahrenheit to 180 degrees Fahrenheit (-40 degrees Celsius to 82.2 degrees Celsius).
- 3.2 The end cap shall be designed to fit over the last corrugation of a chamber, which allows: the capping of each end of the chamber row.
- 3.3 The end cap shall have six upper saw guides capable of accepting pipe O.D. up to 17.81 inches (452 millimeters), five middle saw guides capable of accepting pipe O.D. up to 15.99 inches (406mm) and eight lower saw guides capable of accepting pipe O.D. up to 27.92 inches (709 millimeters) to allow easy cutting for various diameters of pipe that may be used to inlet or outlet the system. See end cap detail for further details.
- 3.4 The end cap shall have excess structural adequacies to allow cutting an orifice of any size at any invert elevation.
- 3.5 The primary face of an end cap shall have five corrugations and be angled outward to resist
- 3.6 The end cap shall be manufactured in an ISO 9001:2008 certified facility.

horizontal loads generated near the edges of beds.

- 3.7 The service life of the product to be over 60 years under a sustained load of 10,000 PSI (68.95 Mpa) which is equal to the H-20 loading condition. 3.8 The nominal storage volume of a Triton S-29 end cap shall be 4.98 cubic feet (0.141 cubic
- meters) per end cap when installed per triton's typical details. This equates to 1.83 cubic feet (0.052 cubic meters) of storage per square foot of bed.
- 4.1 Installation shall be in accordance with the latest Triton Installation manual that can be downloaded from the Triton website: www.tritonsws.com/support/downloads

S-29 PRODUCT SPECIFICATIONS **TRITON - STANDARD DETAILS** 

9.22.2016 ISSUE FOR BIDDING

16076

INFILTRATION STORAGE SYSTEM (OTHER SYSTEMS PROVIDING THE FUNCTIONALITY MAY BE USED) BID ALTERNATE NO. ONE